


Branch XIX

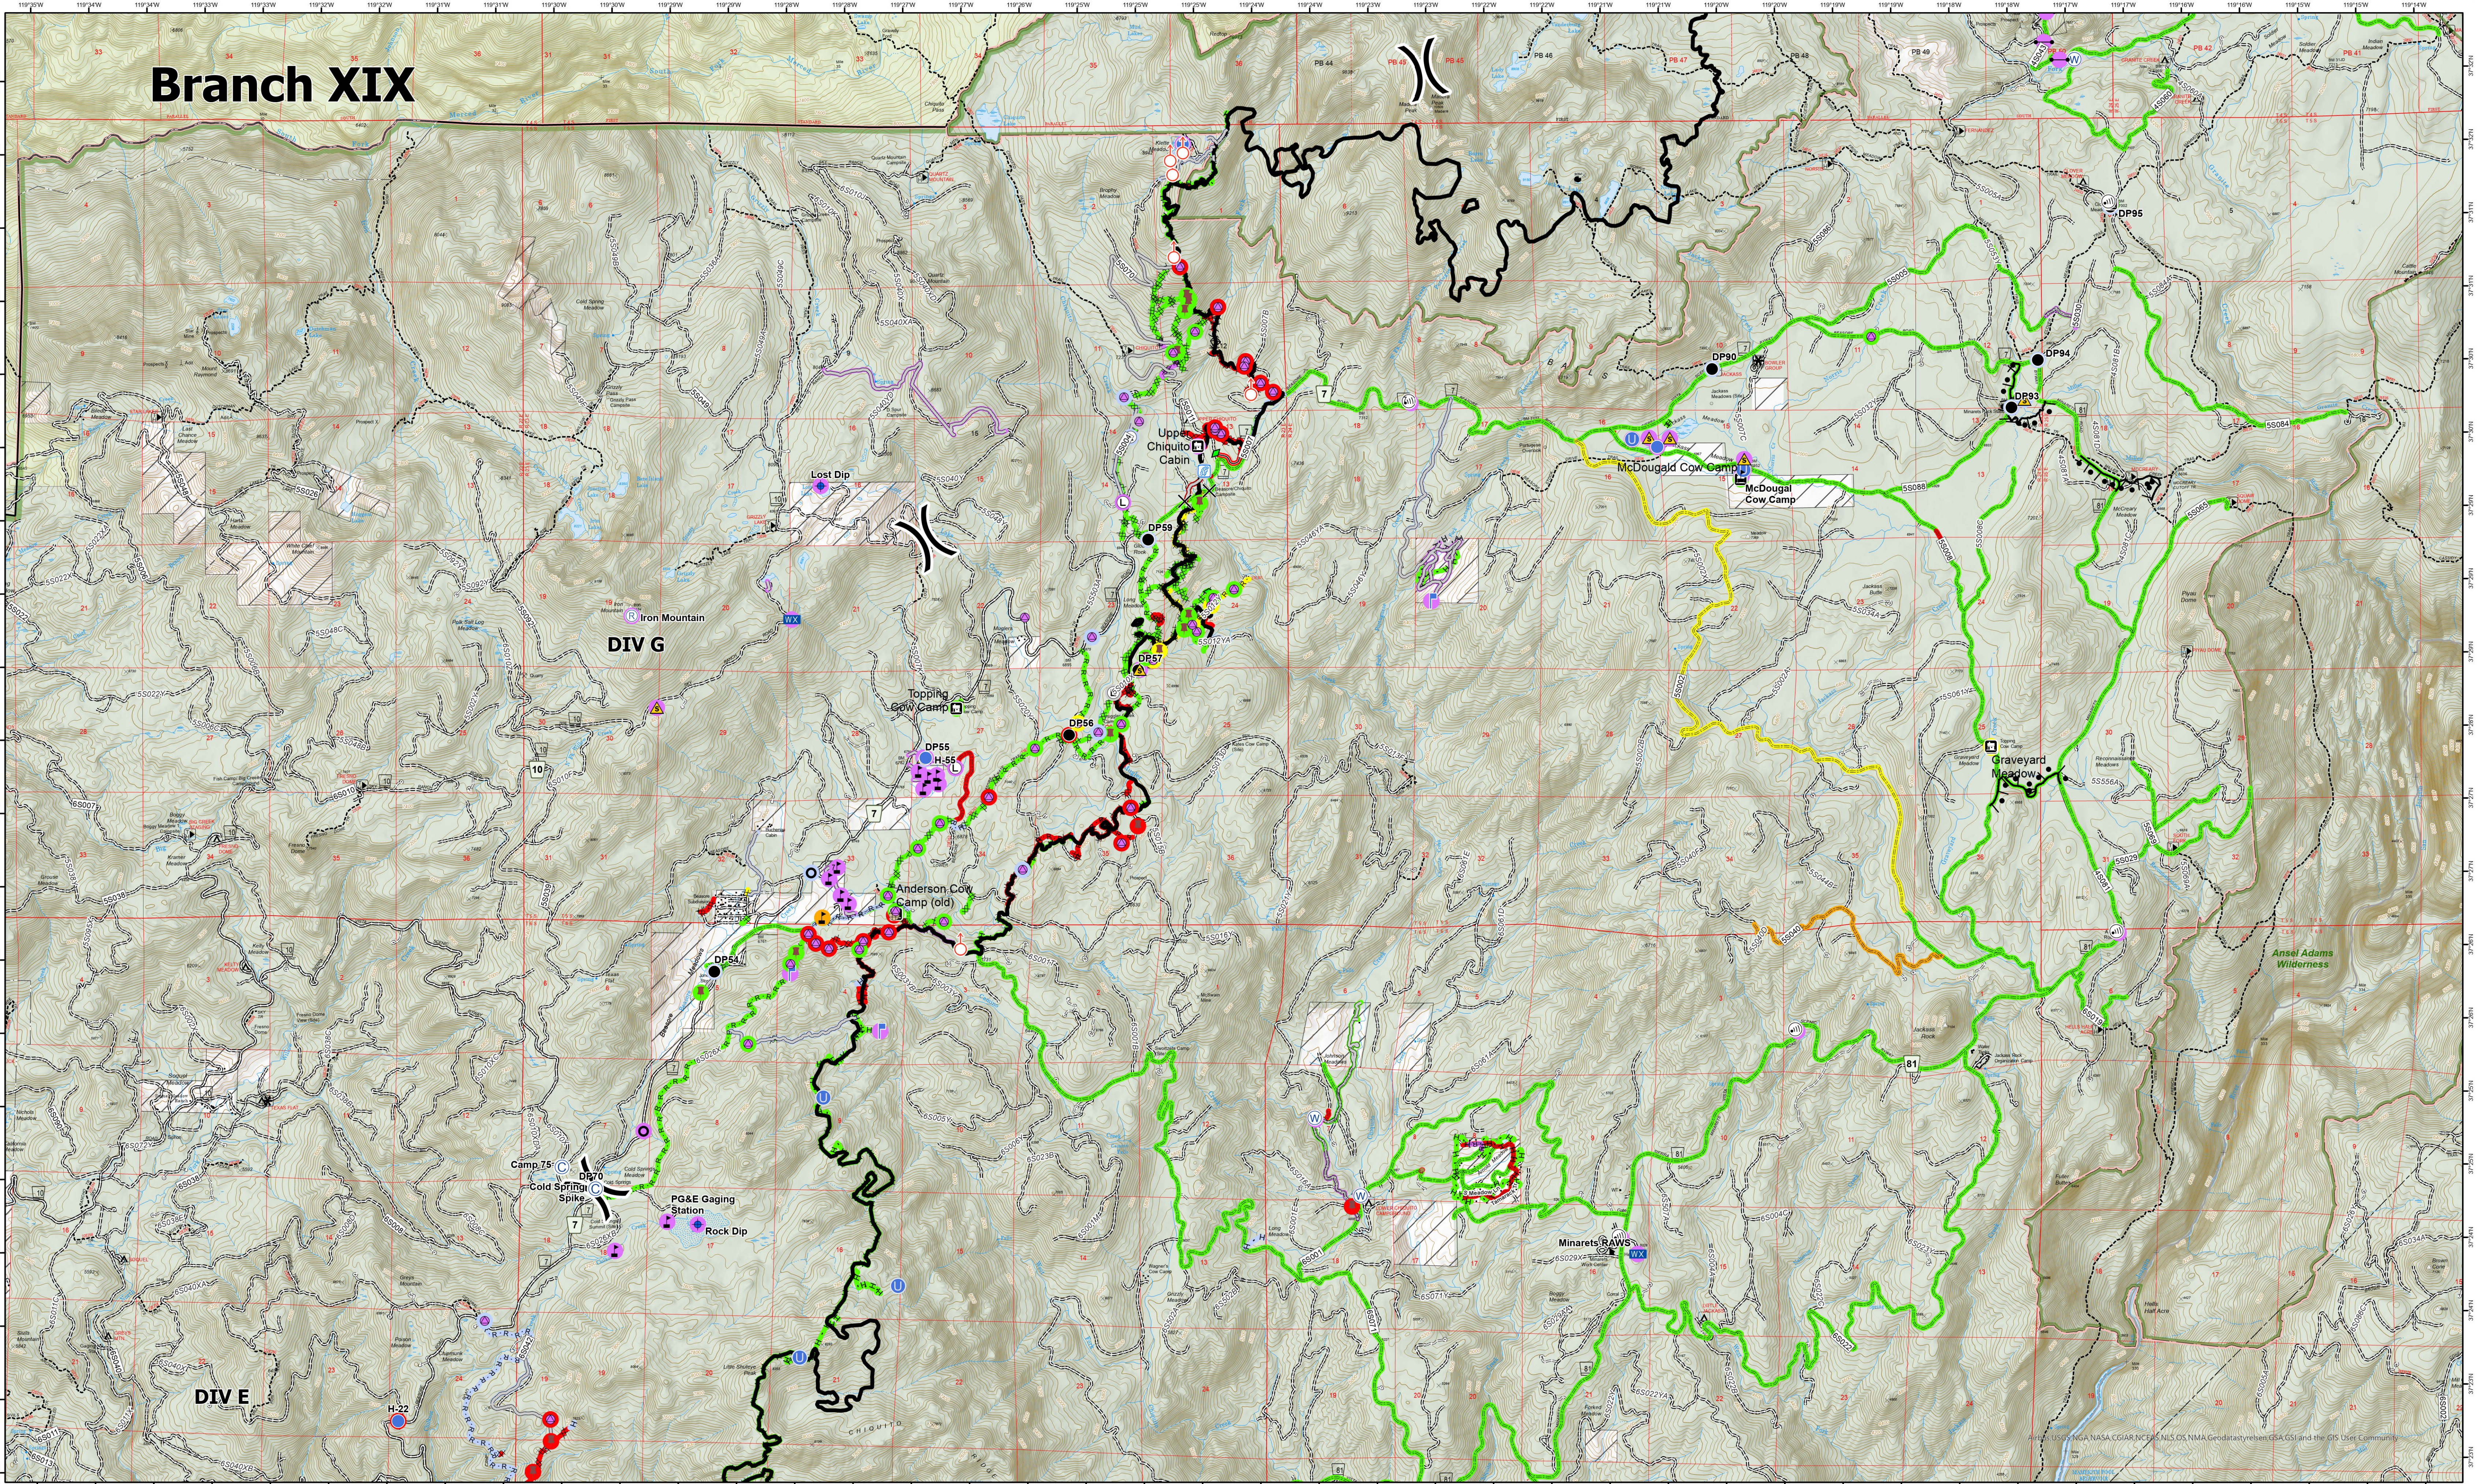

Repair Status Point		Repair Status Line		Other - See Comments		Other - See Comments		Other - See Comments		Other - See Comments									
	Completed - Inspected		Repair Needed		No Repair Needed		Completed - Ready for Inspection		Unknown		Repair Needed		Completed - Inspected		No Repair Needed		Completed - Ready for Inspection		Unknown

Scale: 1:35,000 Name: NAD 1983 California Teale Albers

Contours 40 ft

0 0.5 1 2 Miles

USDA Forest Service Private Lands within the Forest Boundary National Forest Boundary National Park Service

USDA UAS

Page Number: 2