


Suppression Repair Map by Type

Cougar Rock Complex
Owl Fire-Branch 2 IA
IDCTS-000623
OP: 07/21/2021

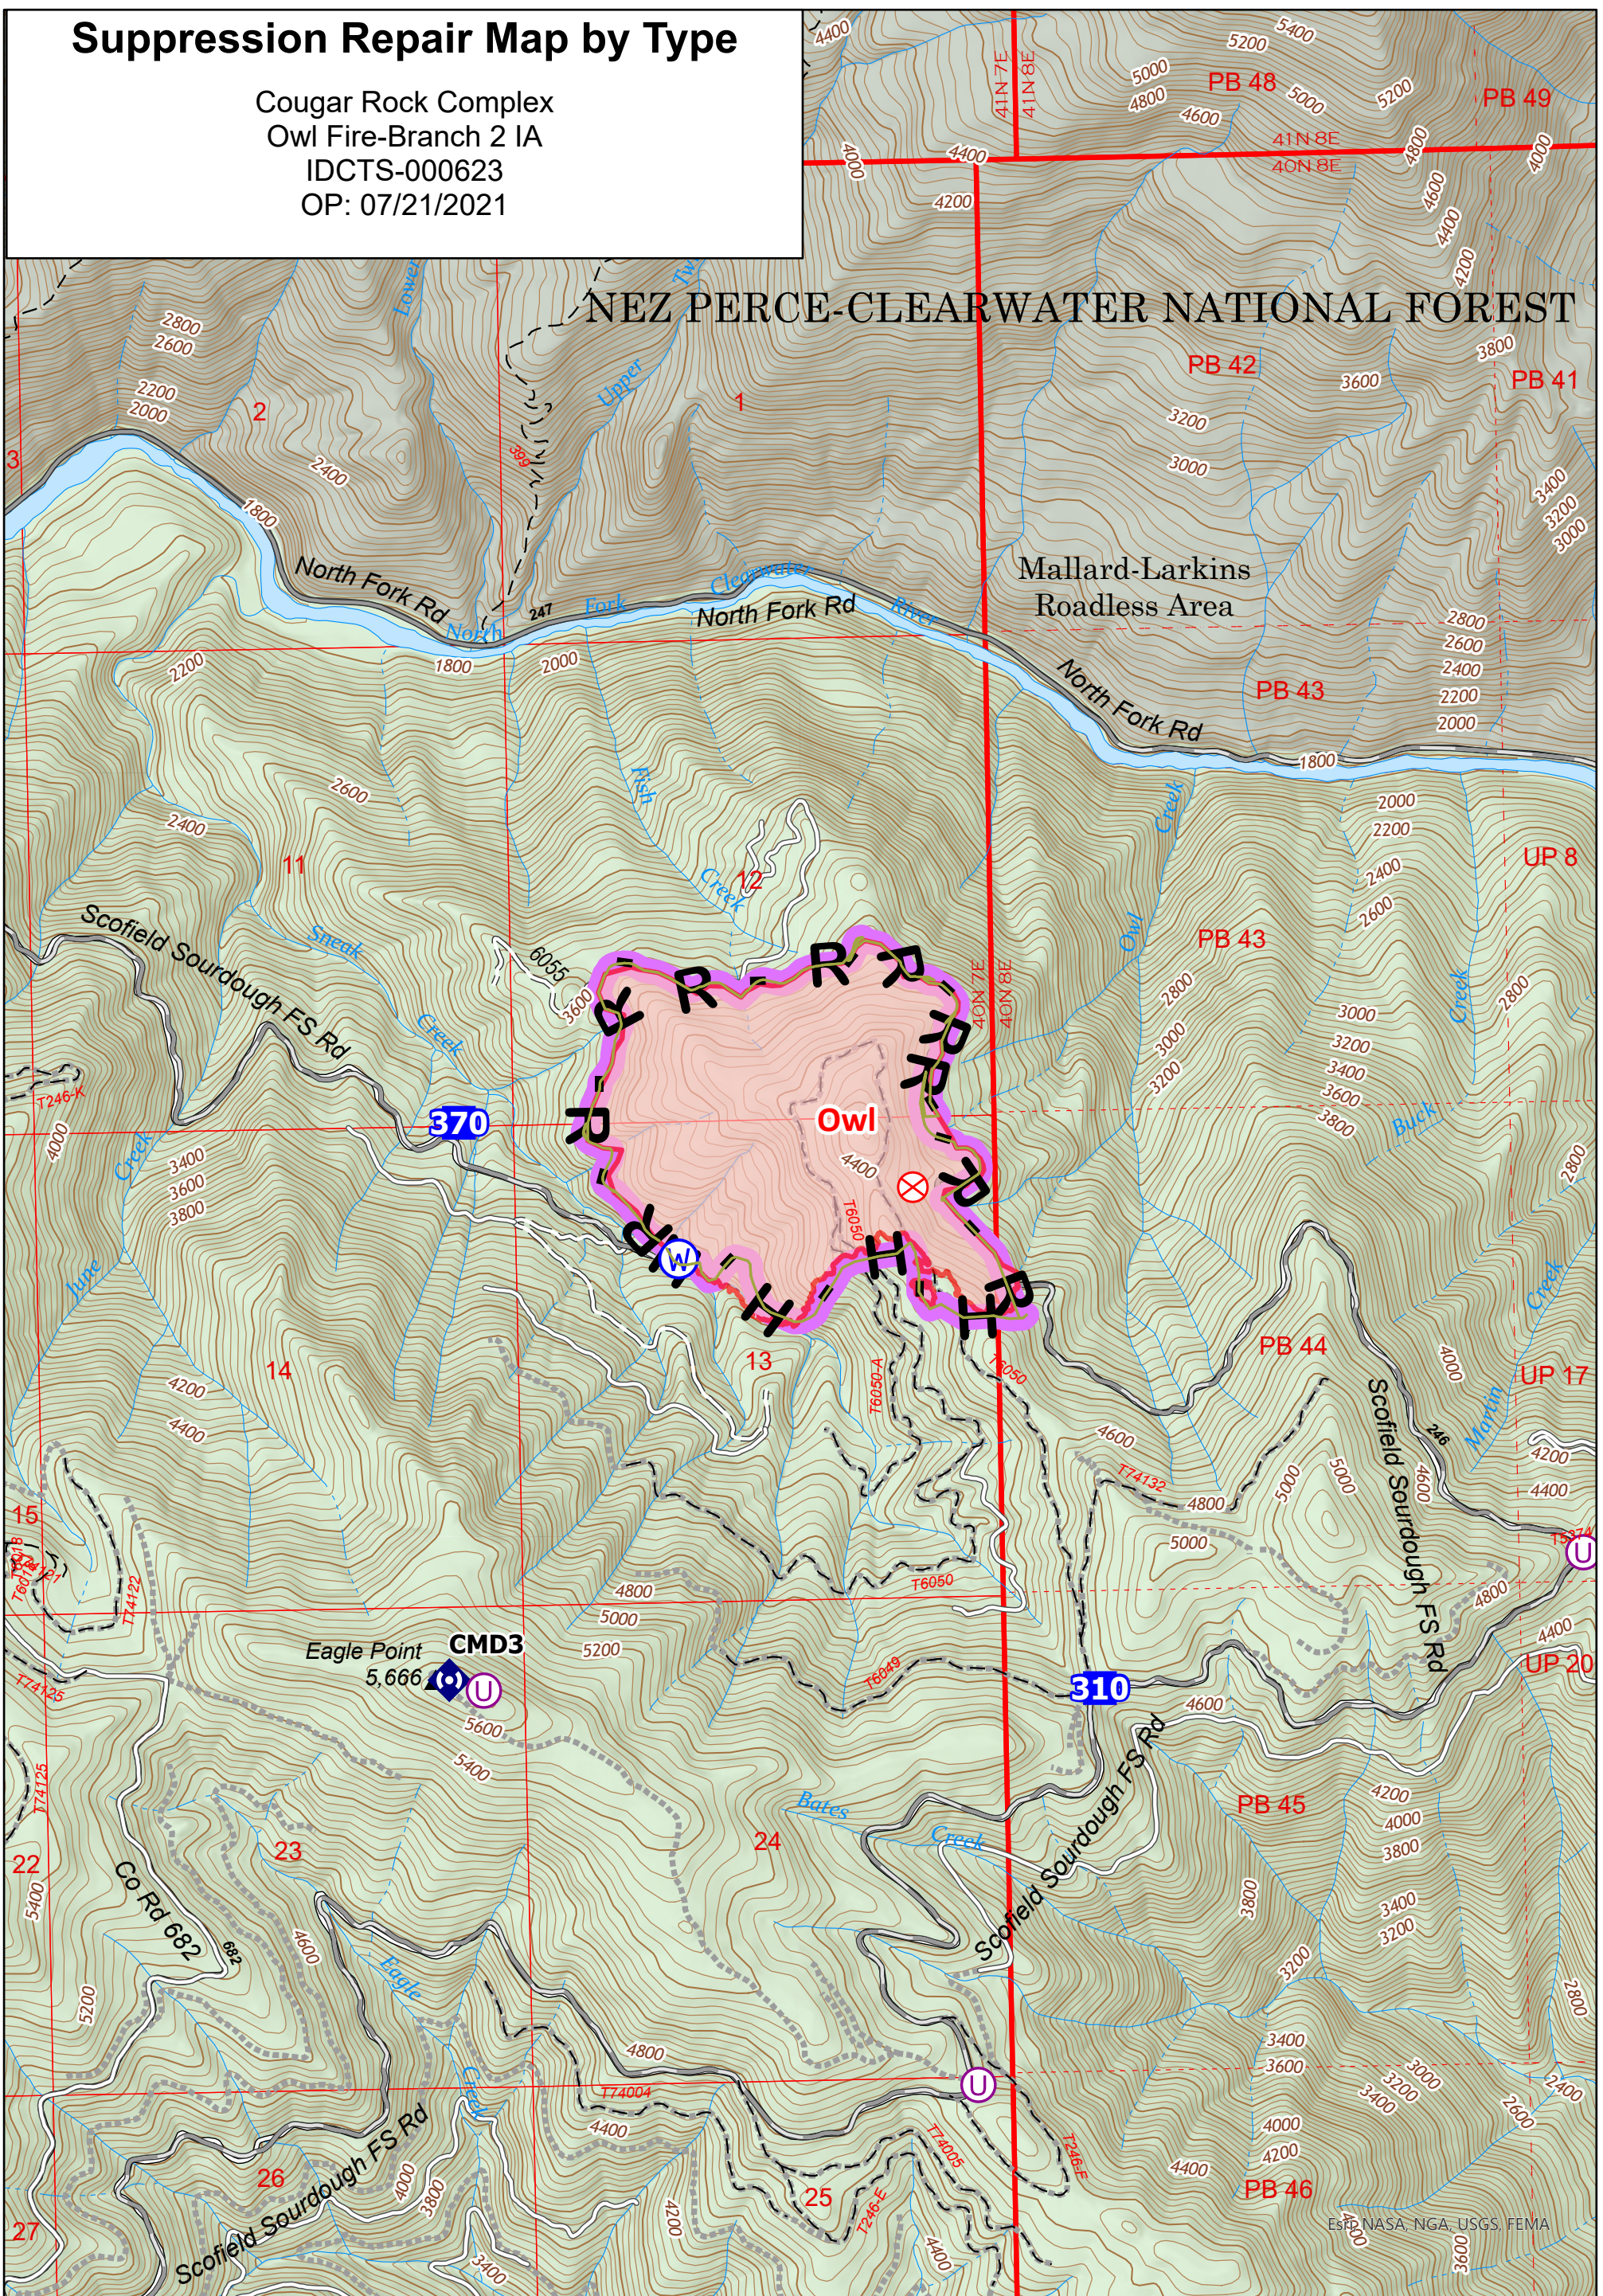

	Wildfire Daily Fire Perimeter		Completed Hand Line		Completed - Ready for Inspection
	Unimproved Landing Area		Completed Road as Line		In Progress
	Drop Point		Paved Roads		Repair Needed
	Fire Origin		Dirt (Not Paved)		No Repair Needed
	Repeater		Forest Service Land		Other - See Comments
	Water Source		USFS Roadless Areas		Unknown
			Repair Status Line		FC_Type_for_Repair
			Completed - Inspected		Repair_Needed_By_Type
			In Use - Fire Management		

0 0.15 0.3 0.45 0.6
Miles

J Connelley 7/20/2021 2050
 North American 1983 Datum, Lat/Long Grid
 PCS: NAD 1983 UTM Zone 11N
 Reference Scale: 1:24,000