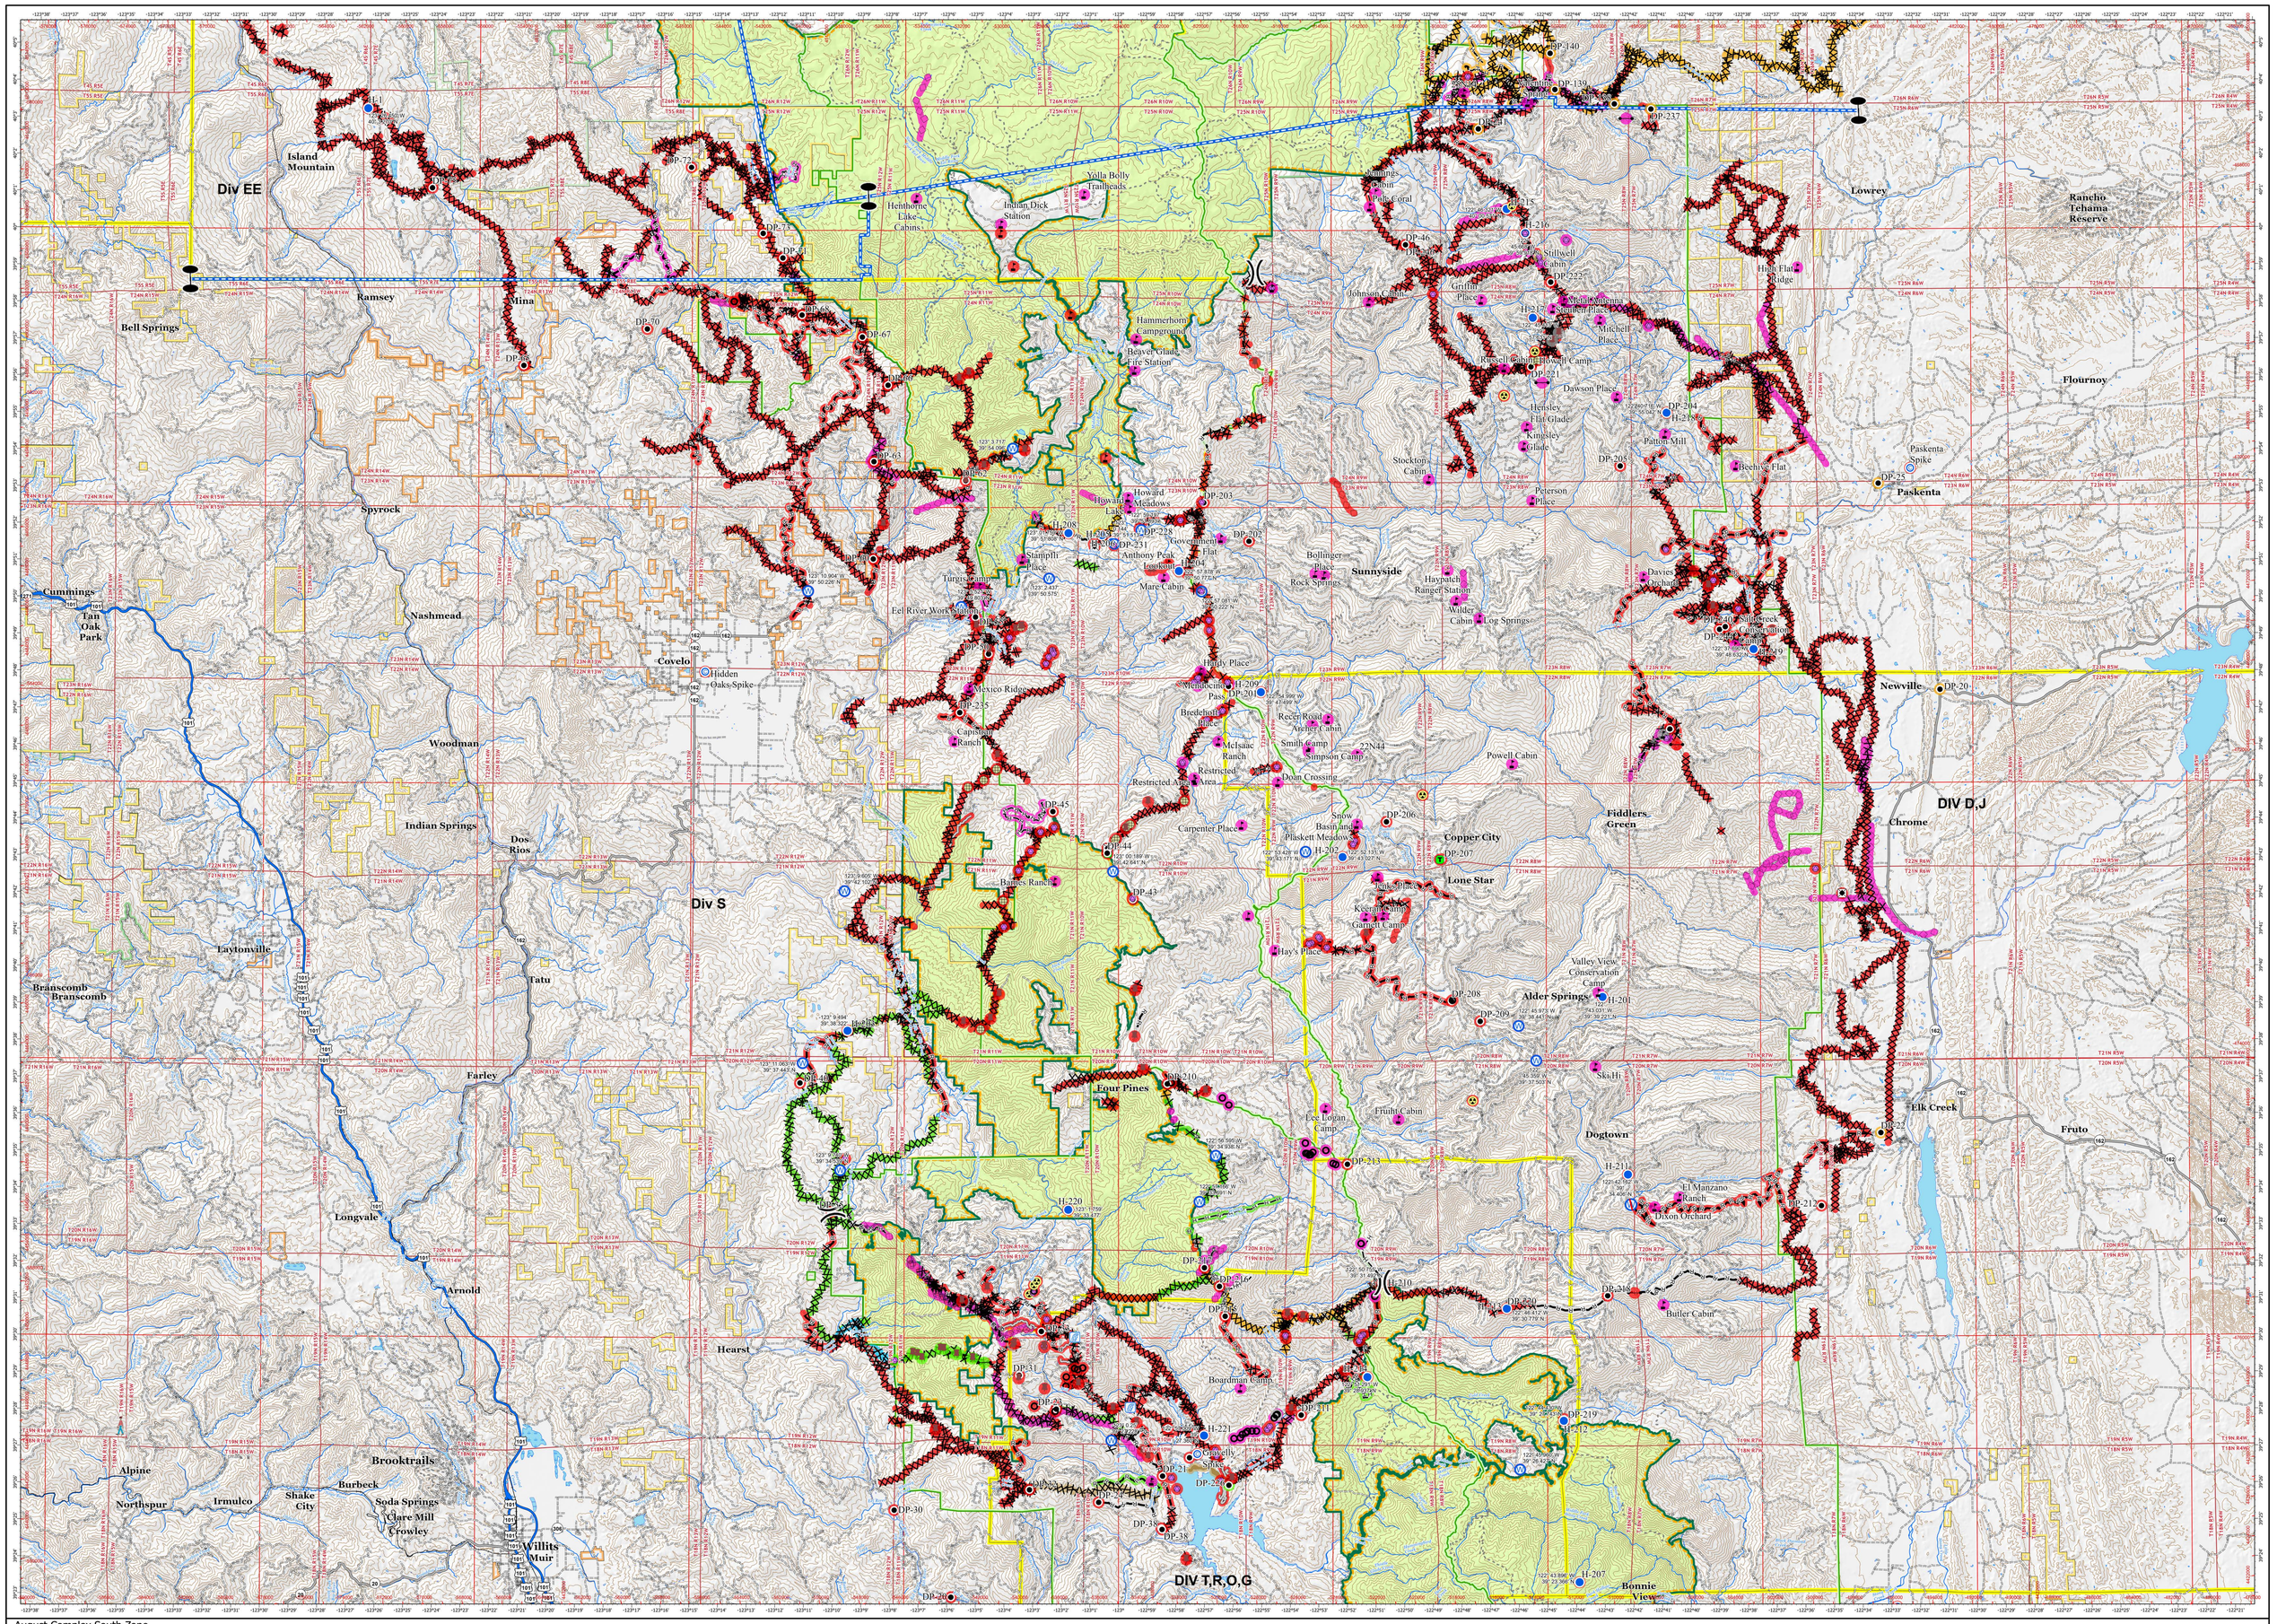

August Complex South Zone
CA-MNF-000753
Incident Repair Status

Operational Period 10/24/2020

GIS Acres 1,032,508
10/23/2020 @ 1500

NAD 1983 UTM Zone 10N

0 0.5 1 2 Miles
0 0.5 1 2 Kilometers
Scale: 1:95,000

Zone Break
Division Break
Zone Break
Access or Improved Road
Repair Line
Road Repair
Fence
Road as Completed Line
Completed Dozer Line
Completed Hand Line
Aerial Retardant Drop
Completed - Inspected
Completed - Ready for Inspection
In Progress
No Repair Needed
Other - See Comments
Repair Needed
Unknown
Repair Point
Fence - Cut/Damaged
Culvert
Road Repair
Hazard
Clean Up Area
Dozer Push
Stream Crossing
Value at Risk
Camp
Drop Point
Gate
Helispot
Restricted Water Source
Water Source
Completed - Inspected
In Progress
No Repair Needed
Other - See Comments
Repair Needed
Unknown
RangerDistrict
Wilderness
Wilderness