



Branch XIX

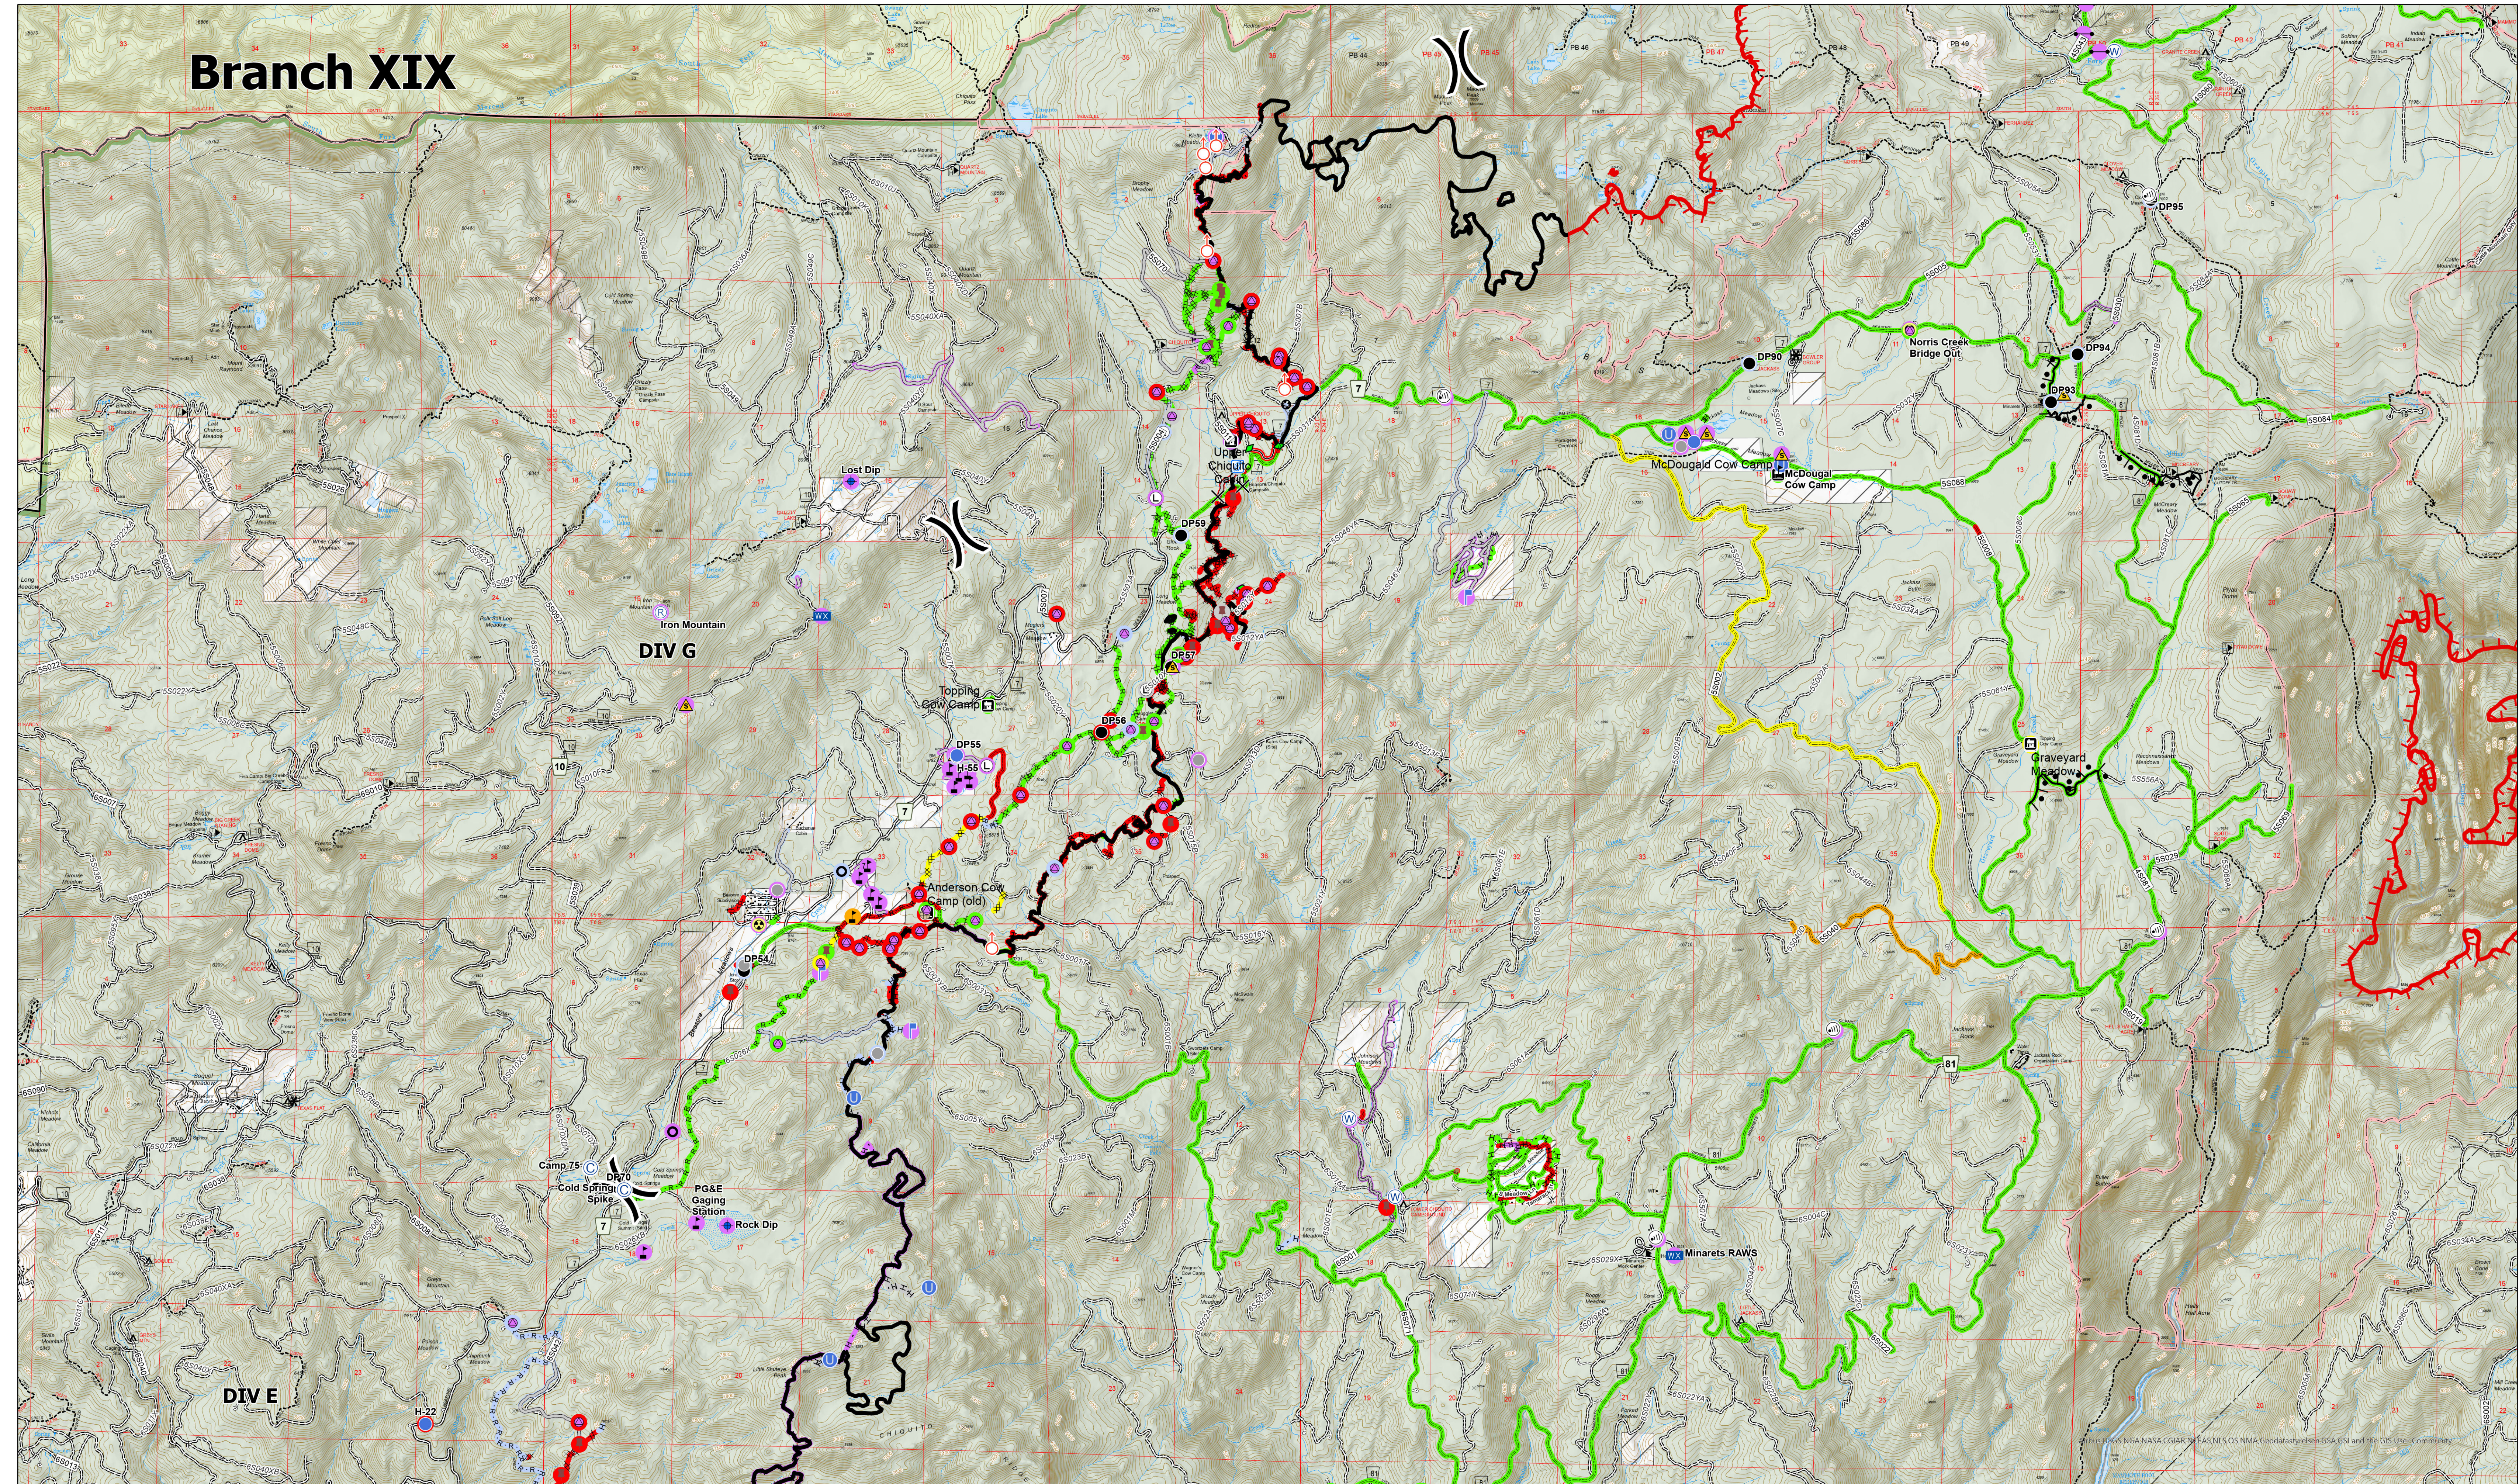

	Repair Status Point	Repair Needed	Completed - Inspected	Completed - Ready for Inspection	In Progress	Bridge	Dip Site	Gate	Internet Access	Repair Point	Stream Crossing	Other	Completed Dozer Line	Completed Flow Line	Road Repair	USDA Forest Service
		No Repair Needed	Other - See Comments	Unknown	Unknown	Camp	Drop Point	Hazard	Landing or Log Deck	Repeater	Structure Wrap	Division Break	Completed Hand Line	Completed Burrow	Other	Private Lands within the Forest Boundary
		Other - See Comments	In Progress	Unknown	Unknown	Closure	Dozer Push	Unimproved Landing Area	Lookout	Safety Zone	Water Source	Uncontrolled Fire Edge	Road as Completed Line	Ridge/Geographic Feature	Other	National Forest Boundary
		Other - See Comments	In Progress	Unknown	Unknown	Culvert	Fence - Cut/Damaged	Helispot	Mobile Weather Unit	Spot Fire	Value at Risk	Contained Line	Access or Improved Road	Repair Line	Other	National Park Service

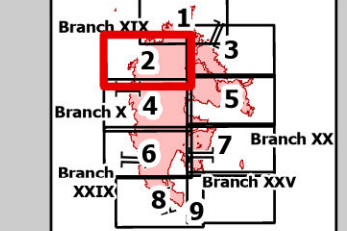

0 0.5 1 2 Miles
 Scale: 1:35,000 Name: NAD 1983 California Teale Albers
 Contours 40 ft

Page Number: 2