
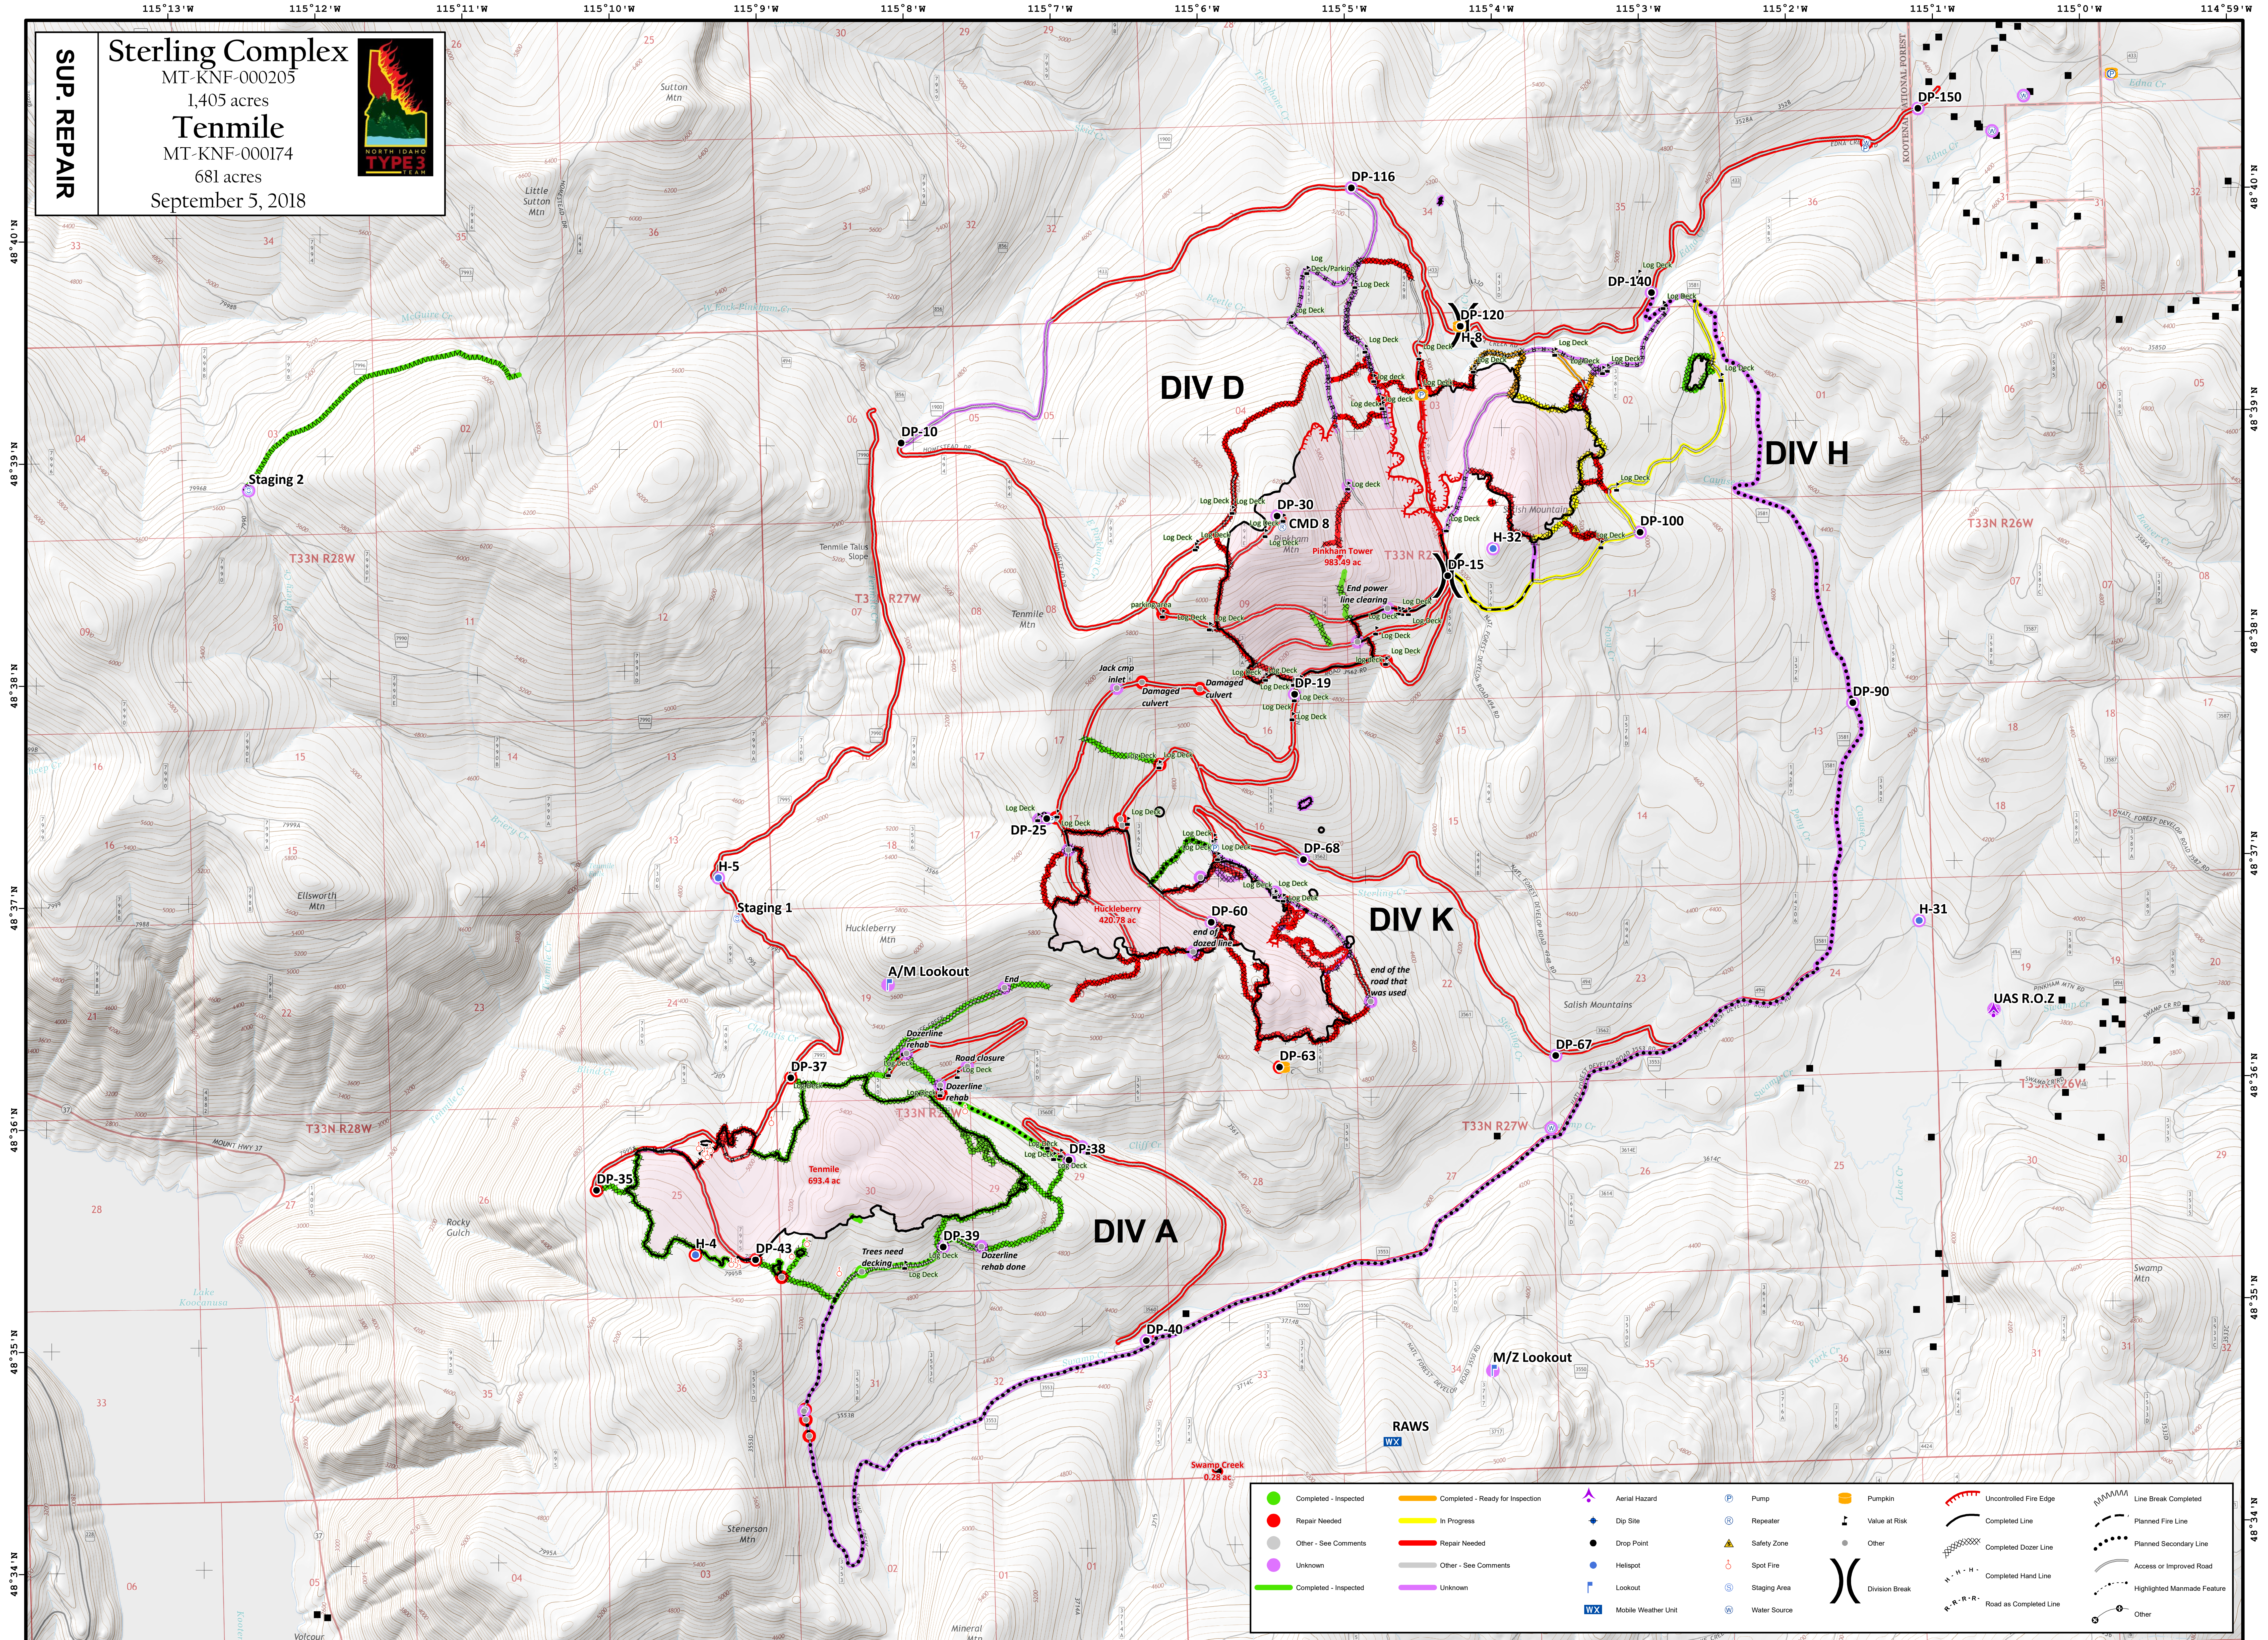


SUP. REPAIR

Sterling Complex
 MT-KNF-000205
 1,405 acres

Tenmile
 MT-KNF-000174
 681 acres

September 5, 2018

	Completed - Inspected		Completed - Ready for Inspection		Aerial Hazard		Pump		Pumpkin		Uncontrolled Fire Edge		Completed Line		Planned Fire Line
	Repair Needed		In Progress		Dip Site		Repeater		Value at Risk		Completed Dozer Line		Planned Secondary Line		Access or Improved Road
	Other - See Comments		Repair Needed		Drop Point		Spot Fire		Other		Completed Hand Line		Highlighted Manmade Feature		Other
	Unknown		Other - See Comments		Handicap		Staging Area		Division Break		Road as Completed Line				
	Completed - Inspected		Unknown		Mobile Weather Unit		Water Source								

Coordinate System: NAD 1983 UTM Zone 11N
 Map Scale: 1:15,840, 1 inch = 1,320 feet

